




SEE SHEET 10 OF 30

SEE SHEET 22 OF 30

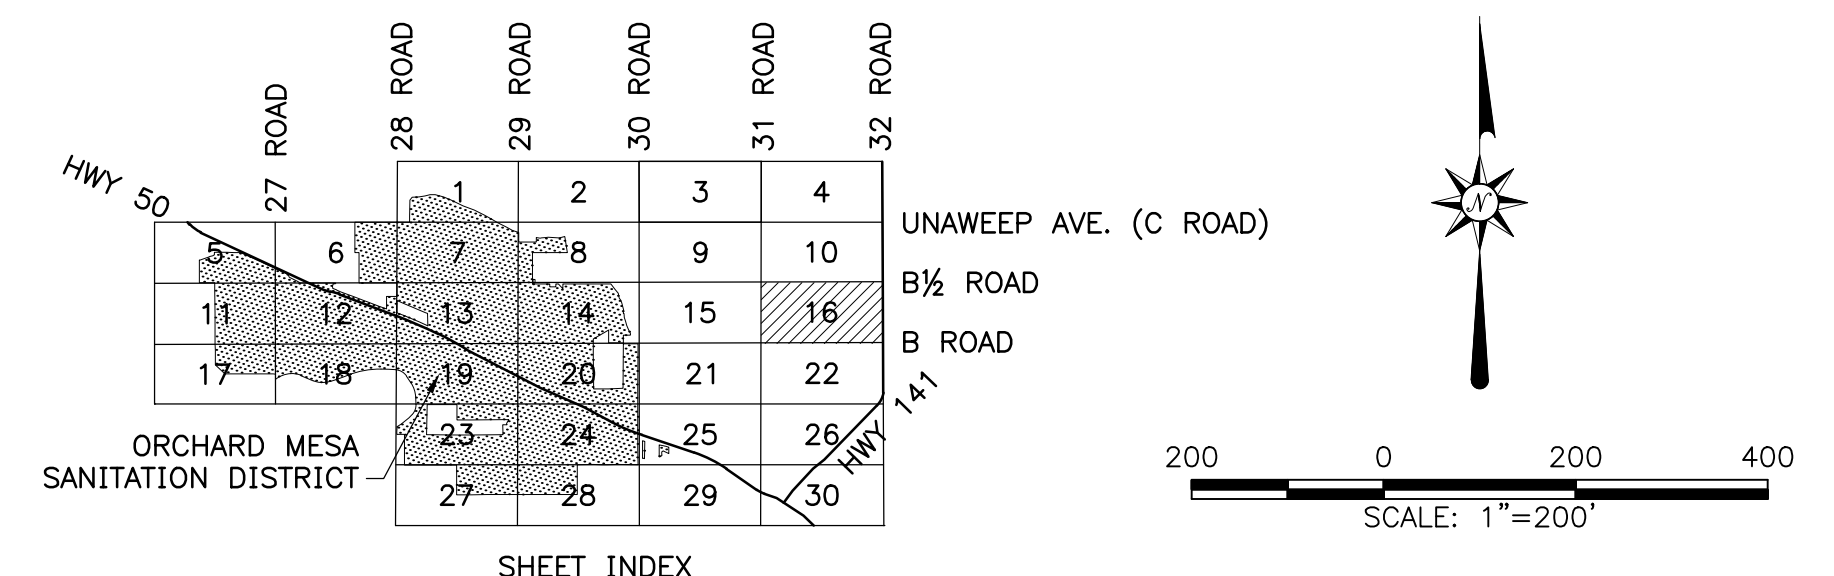

SEE SHEET 15 OF 30

31 ROAD

B 1/2 ROAD

SEC 27  
SW 1/4

SEC 27  
SE 1/4

32 ROAD

B ROAD

MH VV11P  
 4770.67  
 56.28  
 NW 56.13

SCALE: HORIZONTAL 1" = 200'  
 VERTICAL NONE

REVISIONS	DATE
PERIODIC REVIEW	01-14

SECTION 27  
S 1/2

SHEET 16 OF 30

ORCHARD MESA SANITATION DISTRICT  
 SEWAGE COLLECTION SYSTEM  
 GRAND JUNCTION, COLORADO  
 Design by: ADE  
 Drafted by: MJH  
 Date: 09-01  
 Project No. 9844 of 30

**WestWater Engineering**  
 2516 Foresight Circle, #1  
 Grand Junction, CO 81505  
 (970) 241-7076

SOURCE: Parcels from Mesa County Geographic Information System (GIS). Manhole locations from City of Grand Junction, Global Positioning System (GPS) survey in field by LANDesign, 1999-2001 and from as-built drawings. Actual locations may vary.  
 DATUM: North American Vertical Datum 1988 (NAVD 88) used for elevation information.  
 NOTE: This information is for the use of Orchard Mesa Sanitation District for approximate location, size and depth of sanitary sewer lines. This information should not be relied on for design or construction of sanitary sewer lines.